


ALTERATIONS			
MARK	DATE	DESCRIPTION	APPROVED
A	11/11	PLAN CHECKED FROM SHIP AND CORRECTED	
B	11/11	TITLE OF PLAN CHANGED FROM "INBOARD PROFILE" TO "INBOARD PROFILE COMPARTMENT & ACCESS"	

~ ABBREVIATIONS ~

R.F.W.	RESERVE FEED WATER
J.D.	JOINER DOOR
W.T.D.	WATER TIGHT DOOR
N.T.D.	NON TIGHT DOOR
W.T.D.	WEATHER TIGHT DOOR
E.M.D.	EXPANDED METAL DOOR
E.M.B.	EXPANDED METAL BULKHEAD
B.P.	BOLTED PLATE
R.W.T.H.	RAISED WATER TIGHT HATCH
R.W.T.M.H.	RAISED WATER TIGHT MANHOLE
F.O.T.M.H.	FLUSH OIL TIGHT MANHOLE
R.O.T.M.H.	RAISED OIL TIGHT MANHOLE
E.S.C.	ESCAPE SCUTTLE
R.W.T.COM.H.	RAISED WATER TIGHT COMPANION HATCH
A.T.H.	AIR TIGHT HATCH
A.T.D.	AIR TIGHT DOOR
A.L.D.	ALUMINUM DOOR
F.O.T.S.M.H.	FLUSH OIL TIGHT BOLTED MANHOLE
W.T.	WATER TIGHT
V.L.	VERTICAL LADDER
STAN.	STANCHION
O.T.	OIL TIGHT
O.D.	OUTSIDE DIAMETER
RAD.	RADIUS
W.T.S.M.H.	WATERTIGHT BOLTED MANHOLE
STBD.	STANDARD
INCL.	INCLINED
AL.J.D.	ALUMINUM JOINER DOOR
F.T.	FUME TIGHT
F.D.N.	FOUNDATION
B.L.	BASE LINE
W.T.A.L.D.	WATERTIGHT AIR LOCK DOOR
MAG.	MAGAZINE
W.R.	WARDROOM
W.C.	WATER CLOSET
I.S.	INSECT SCREEN
B.H.	BULKHEAD
F.T.	FUME TIGHT

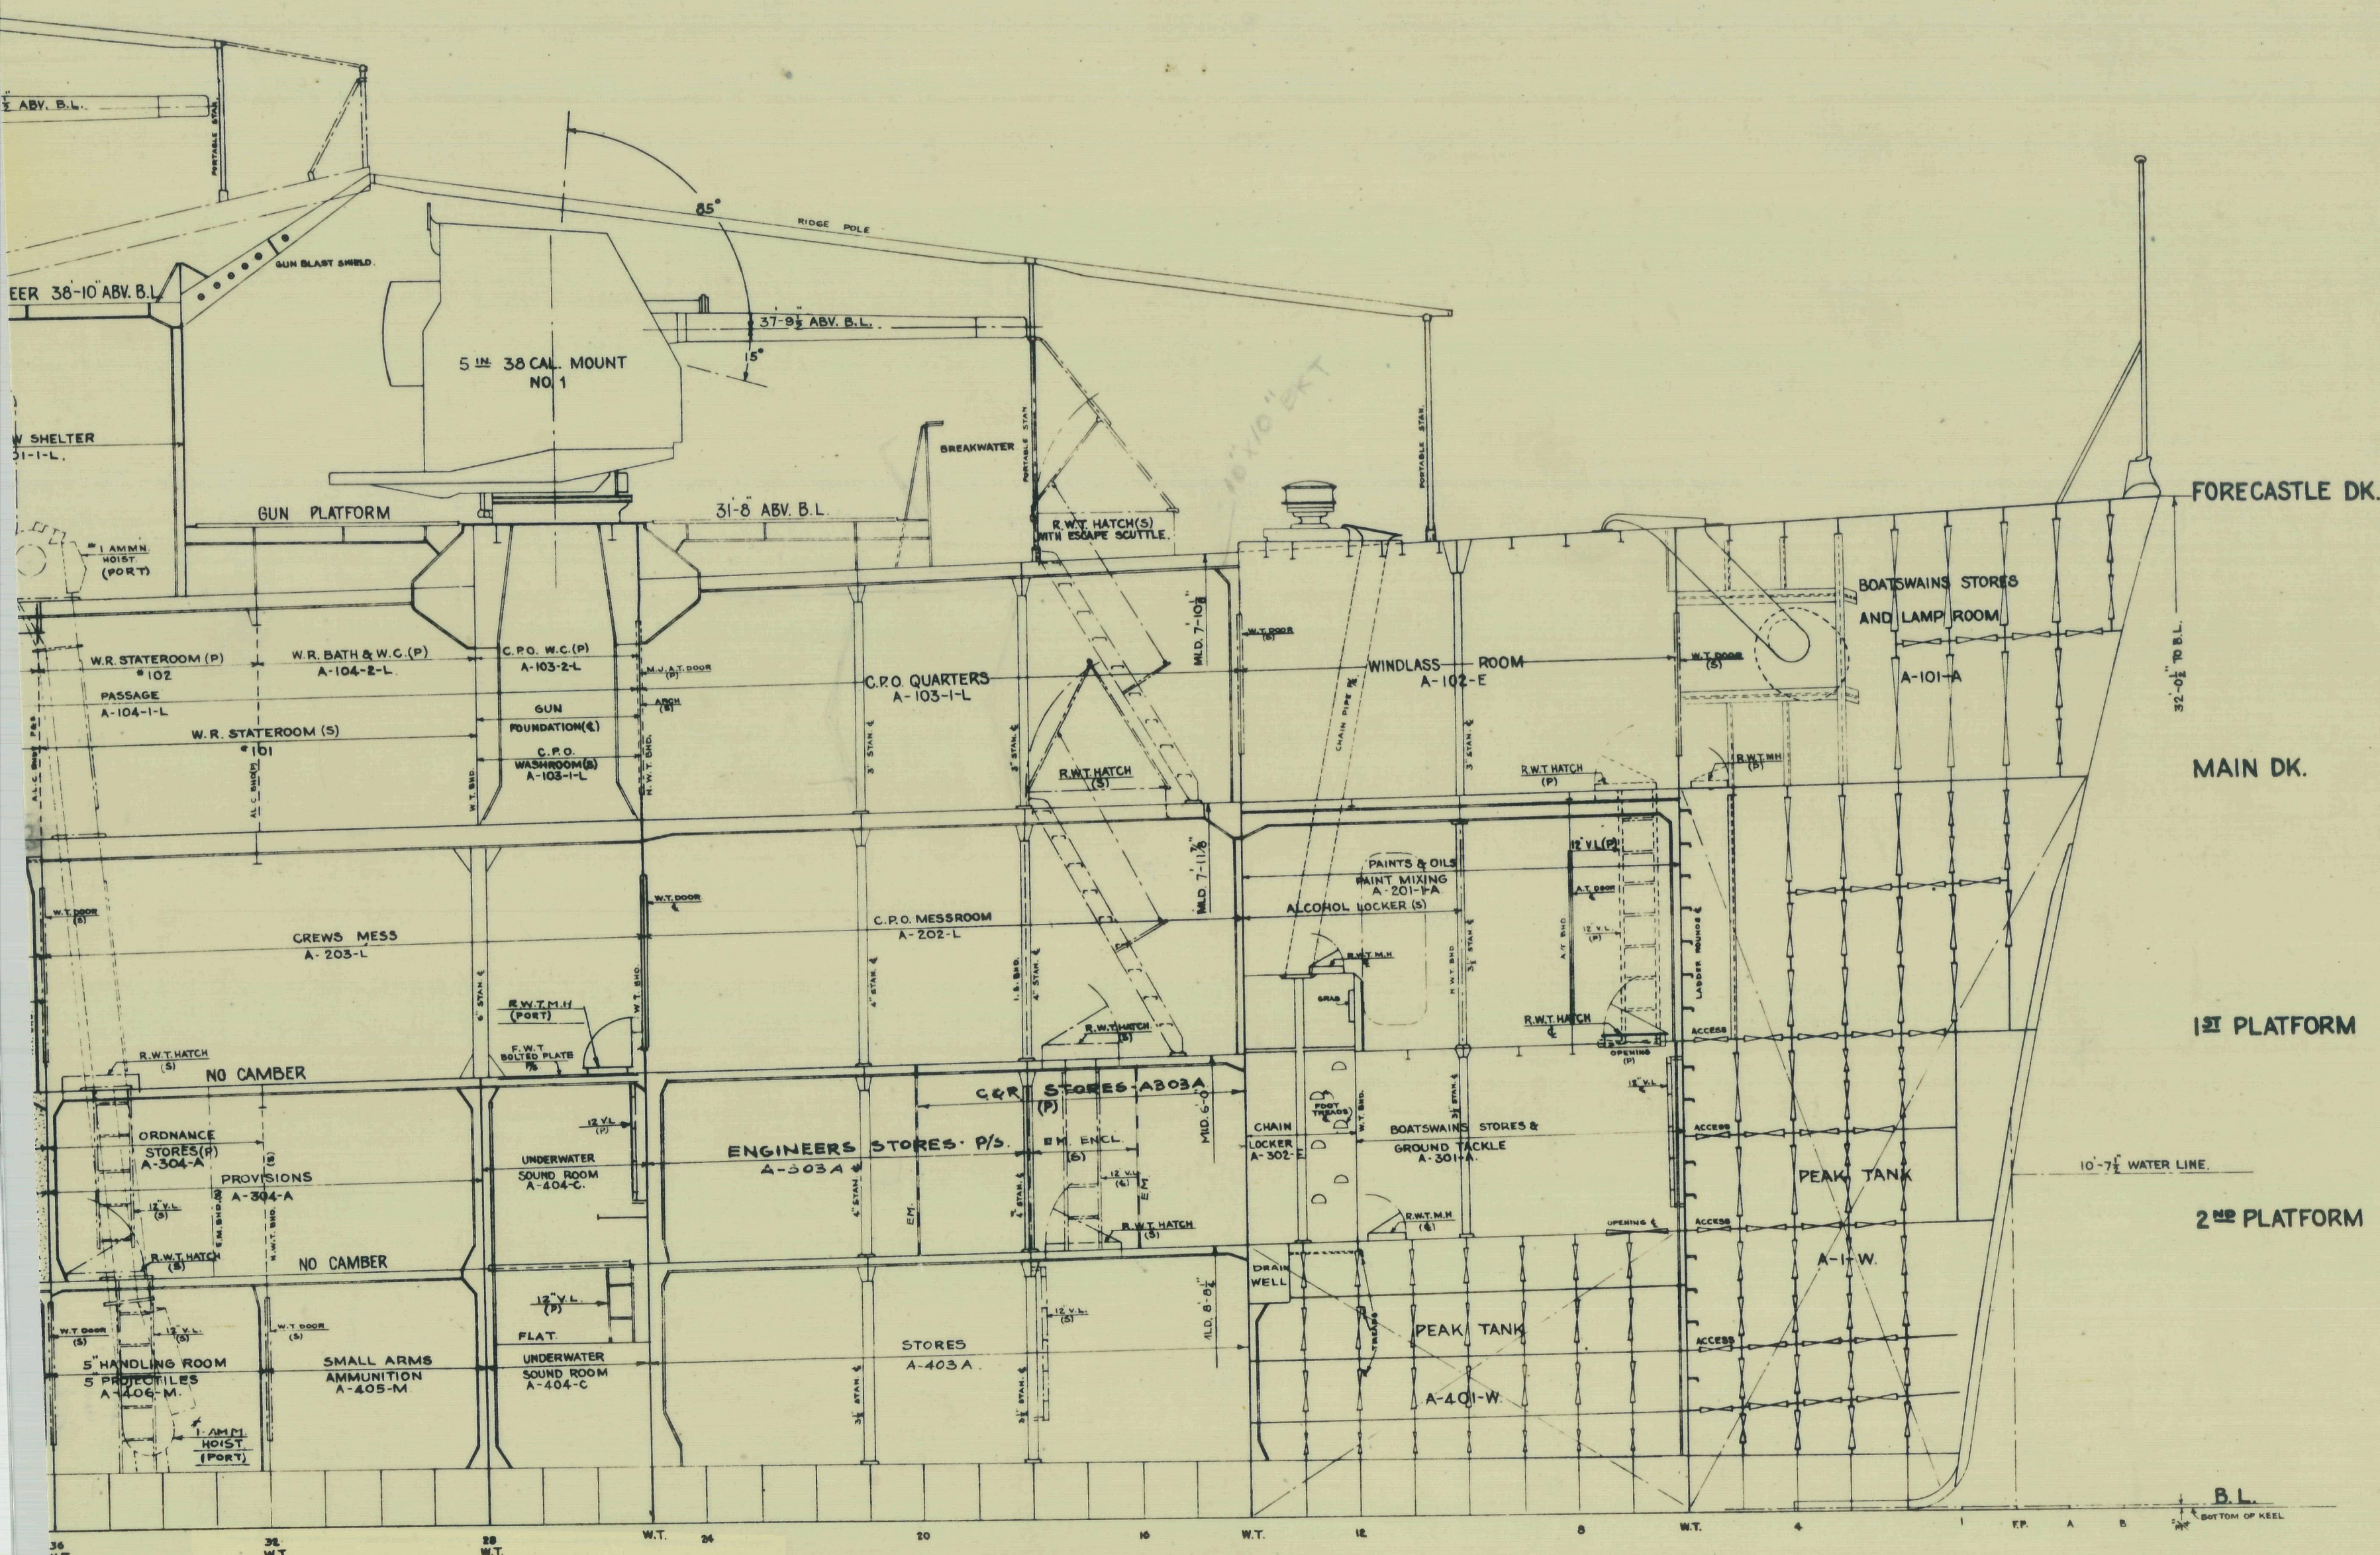

U.S.S. CONYNGHAM
DD 371

FINISHED PLAN

TAKEN FROM WORK, EXAMINED
AND FOUND CORRECT

NAVY YARD BOSTON

DATE AUG 2, 1938 *Rm Rush*
APPROVED FOR MANAGER

BU. C. & R. NO. 223765

UNITED DESIGN DEPARTMENT
UNITED DRY DOCKS INC.
NEW YORK CITY

DESIGN AND ENGINEERING BY
GIBBS & COX INC.
NEW YORK CITY

B.D. 364 USS MAHAN
B.D. 365 USS DUMMINGS

INBOARD PROFILE
COMPARTMENT & ACCESS

SCALE 1/4" = 1'-0" DATE FEB 11, 1936
DRAWN BY J.M. EXAMINED J.W. Sutton
TRACED BY J.M. APPROVED L.A. Hester
CHECKED BY J.M. APPROVED L.A. Hester

DR. N° 3645-0101-3

CENTRAL DRAFTING OFFICE
C. & R.
NAVY YARD, NEW YORK.

APPROVED FOR DD370 TO 379 BY
J.M. Merrill
PRINCIPAL NAVAL ARCHITECT
Aug. 18, '36
R.D. Hester
CAPT. 1601 DAA.

BU. C. & R. # 223765
BASIC C. & R. N° 241056